

AS BUILT FARM 7 PERIMETER OF THE SHEDS (SHOWN IN RED) AS SURVEYED BY LAND MANAGEMENT SURVEYS ON 20-04-2023 UNDER SUPERVISION OF LICENSED LAND SURVEYOR PETER MORRISON.

F	SHIFTED FARM 10 & 11 LOCATIONS	JD	10-08-2023
G	MARKUPS TO FARM 10 & 11	JD	24-08-2023
H	MARKUPS TO FARM 10 & 11 (SHEDS & BUFFER ZONE)	NR	14-03-2024
I	LAYOUT AMENDED	NR	22-03-2024
J	AERIAL IMAGE UPDATED	LW	20-06/2024
REV	REVISION	BY	DATE
			SHEET No.

NOTES

- AERIAL PHOTOGRAPH TAKEN FROM GOOGLE MAPS
- ALL PLANNING DATA HAS COME FROM VICTORIAN STATE GOVERNMENT "VicPlan" WEBSITE
- ABORIGINAL CULTURAL HERITAGE SENSITIVITY OVERLAY
- LAND SUBJECT TO INUNDATION OVERLAY
- VEGETATION PROTECTION OVERLAY
- HERITAGE REGISTER
- VICTRACK PROPERTY OVERLAY

DESIGNED DATE	NM	20-02-2023
DRAWN DATE	NM	20-02-2023
CHECKED DATE		

LAND MANAGEMENT SURVEYS (MELBOURNE)
 SURVEYORS ENGINEERS PLANNERS
 ABN 22 057 933 516
 34 BALCOMBE ROAD MENTONE 3194
 Ph. (03) 9583 0888 Fax. (03) 9583 5888

DRG FILE No. O:\SH2023\4114 - Baringhup Road Carisbrook (LMS 12046 ABCDE)\IC3D\12046E_Engineering_Farm_10_02_LW.dwg

POULTRY FARM
BALD HILL ROAD
CARISBROOK
FARM 10 - LOCALITY PLAN

SCALE 1 : 10,000 @ A1
SHEET 1 OF 8
REVISION J
FILE No. 12046E



AS BUILT FARM 7 PERIMETER OF THE SHEDS (SHOWN IN RED) AS SURVEYED BY LAND MANAGEMENT SURVEYS ON 20-04-2023 UNDER SUPERVISION OF LICENSED LAND SURVEYOR PETER MORRISON.

F	SHIFTED FARM 10 & 11 LOCATIONS	JD	10-08-2023
G	MARKUPS TO FARM 10 & 11	JD	24-08-2023
H	MARKUPS TO FARM 10 & 11 (SHEDS & BUFFER ZONE)	NR	14-03-2024
I	LAYOUT AMENDED	NR	22-03-2024
J	AERIAL IMAGE UPDATED	LW	20-06-2024
REV	REVISION	BY	DATE
			SHEET No.

NOTES

- AERIAL PHOTOGRAPH TAKEN FROM GOOGLE MAPS
- ALL PLANNING DATA HAS COME FROM VICTORIAN STATE GOVERNMENT "VicPlan" WEBSITE
- ABORIGINAL CULTURAL HERITAGE SENSITIVITY OVERLAY
- LAND SUBJECT TO INUNDATION OVERLAY
- VEGETATION PROTECTION OVERLAY
- HERITAGE REGISTER
- VICTRACK PROPERTY OVERLAY

DESIGNED DATE	NM	20-02-2023
DRAWN DATE	NM	20-02-2023
CHECKED DATE		

LAND MANAGEMENT SURVEYS (MELBOURNE)
 SURVEYORS ENGINEERS PLANNERS
 ABN 22 057 933 516
 34 BALCOMBE ROAD MENTONE 3194
 Ph. (03) 9583 0888 Fax. (03) 9583 5888

DRG FILE No. O:\SH2023\4114 - Barrington Road Carrisbrook (LMS 12046 ABCDE)\IC3D\12046E_Engineering_Farm_10_02_LW.dwg

POULTRY FARM		SCALE 1 : 4000 @ A1
BALD HILL ROAD		SHEET 2 OF 8
CARISBROOK		REVISION J
FARM 10 - LAYOUT PLAN		FILE No. 12046E



F	SHIFTED FARM 10 & 11 LOCATIONS	JD	10-08-2023
G	MARKUPS TO FARM 10 & 11	JD	24-08-2023
H	MARKUPS TO FARM 10 & 11 (SHEDS & BUFFER ZONE)	NR	14-03-2024
I	LAYOUT AMENDED	NR	22-03-2024
J	AERIAL IMAGE UPDATED	LW	20-06-2024
REV	REVISION	BY	DATE
			SHEET No.

NOTES

1. THIS

DESIGNED DATE	NM	20-02-2023
DRAWN DATE	NM	20-02-2023
CHECKED DATE		











LAND MANAGEMENT SURVEYS (MELBOURNE)
 SURVEYORS ENGINEERS PLANNERS
 ABN 22 057 933 516
 34 BALCOMBE ROAD MENTONE 3194
 Ph. (03) 9583 0888 Fax. (03) 9583 5888

DRG FILE No. O:\SH2023\4114 - Barrington Road Carisbrook (LMS 12046 ABCDE)\JC3D12046E_Engineering_Farm_10_02_LW.dwg

POULTRY FARM
 BALD HILL ROAD
 CARISBROOK

FARM 10 - DETAIL PLAN

SCALE 1:500 @ A1
 SHEET 3 OF 8
 REVISION J
 FILE No. 12046E

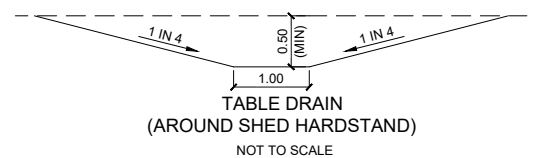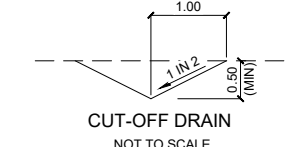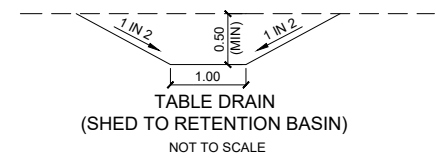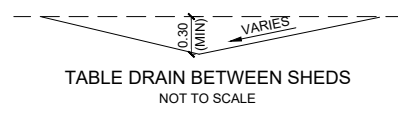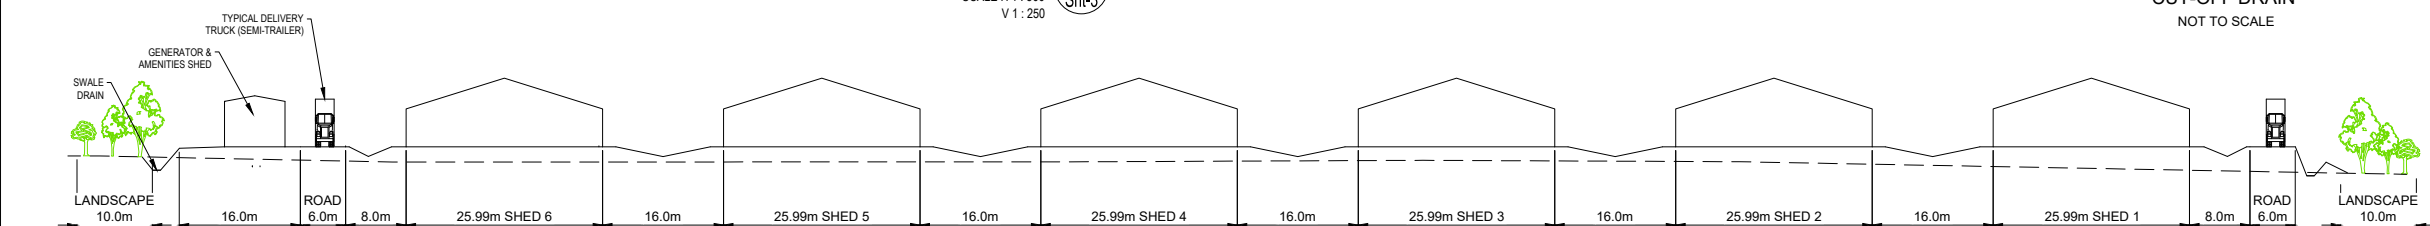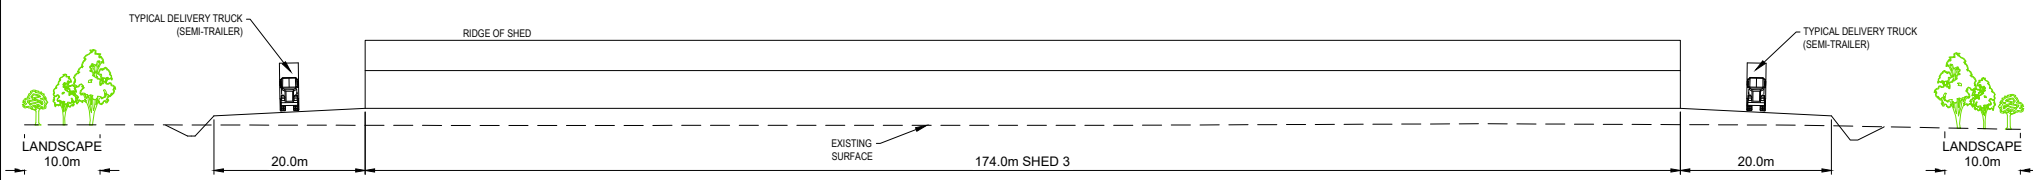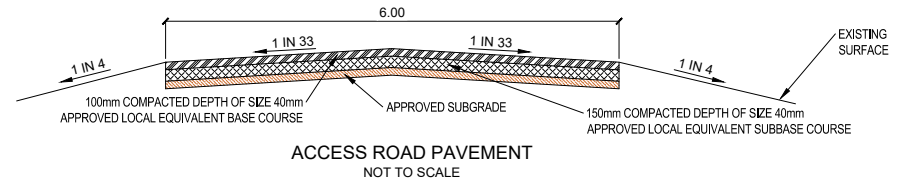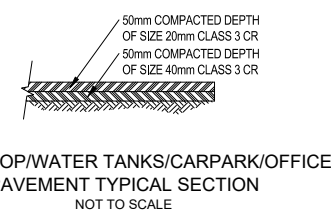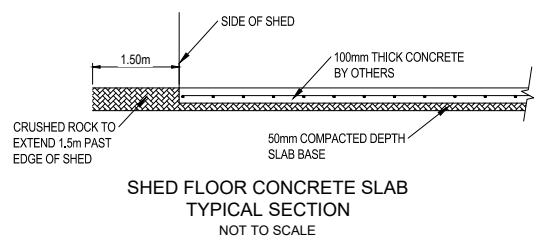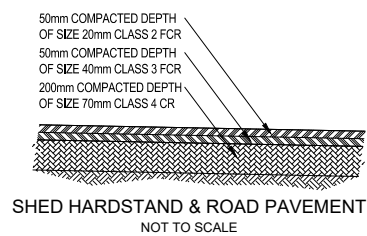

A	PRELIMINARY ISSUE	NM	23-02-2023	
B	SHIFTED FARM 10 LOCATION	JD	10-08-2023	
C	MARKUPS TO FARM 10	JD	24-08-2023	
D	SHED SIZE AMENDED	NR	14-03-2024	
E	DETAILS AMENDED	NR	22-03-2024	
REV	REVISION	BY	DATE	SHEET No.

NOTES

DESIGNED DATE: NM 20-02-2023
DRAWN DATE: NM 20-02-2023
CHECKED DATE:


LAND MANAGEMENT SURVEYS (MELBOURNE)
SURVEYORS ENGINEERS PLANNERS
ABN 22 057 933 516
34 BALCOMBE ROAD MENTONE 3194
Ph. (03) 9583 0888 Fax. (03) 9583 5888

DRG FILE No. O:\SH2023\4114 - Barrington Road Carrisbrook (LMS 12046 ABCDE)\IC3D\12046E_Engineering_Farm_10_02_LW.dwg


POULTRY FARM
BALD HILL ROAD
CARISBROOK

FARM 10 - SECTIONS, RESIDENCE, DAM & BUILDINGS


SCALE AS SHOWN @ A1
SHEET 4 OF 8
REVISION E
FILE No. 12046E

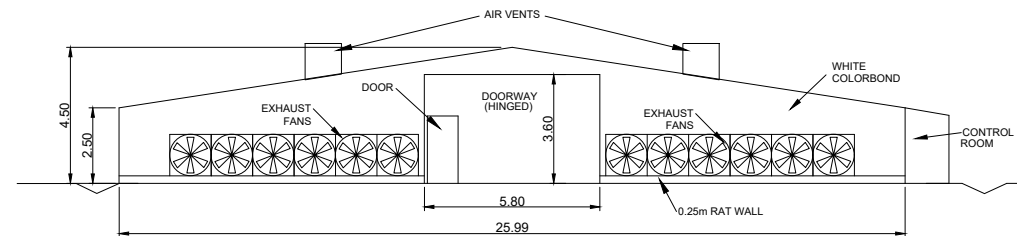


FAN END
SCALE 1:125

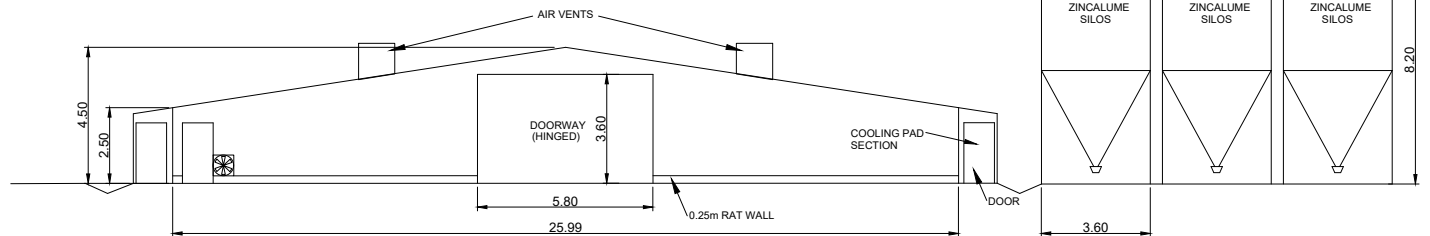


COOLING PAD END
SCALE 1:125

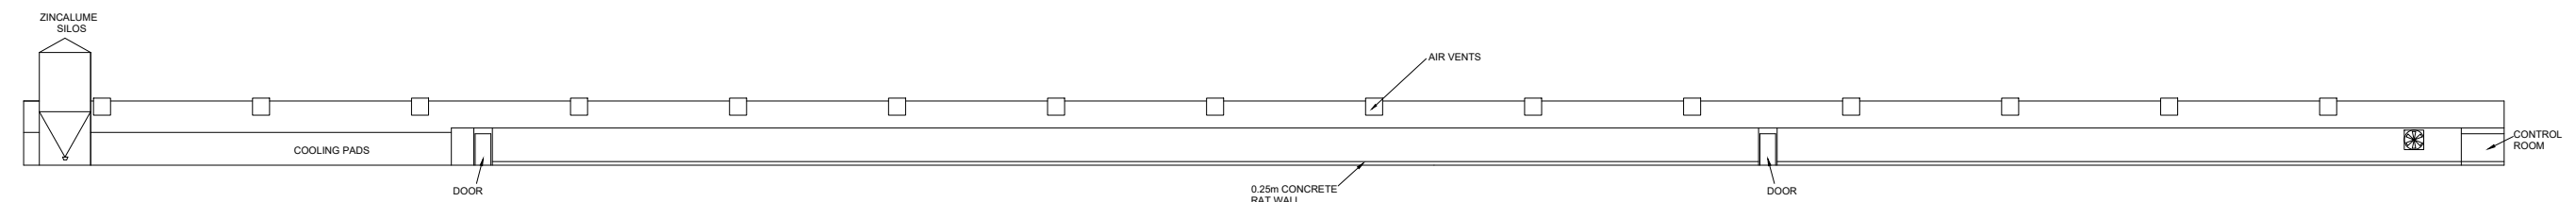

EAST ELEVATION
SCALE 1:250

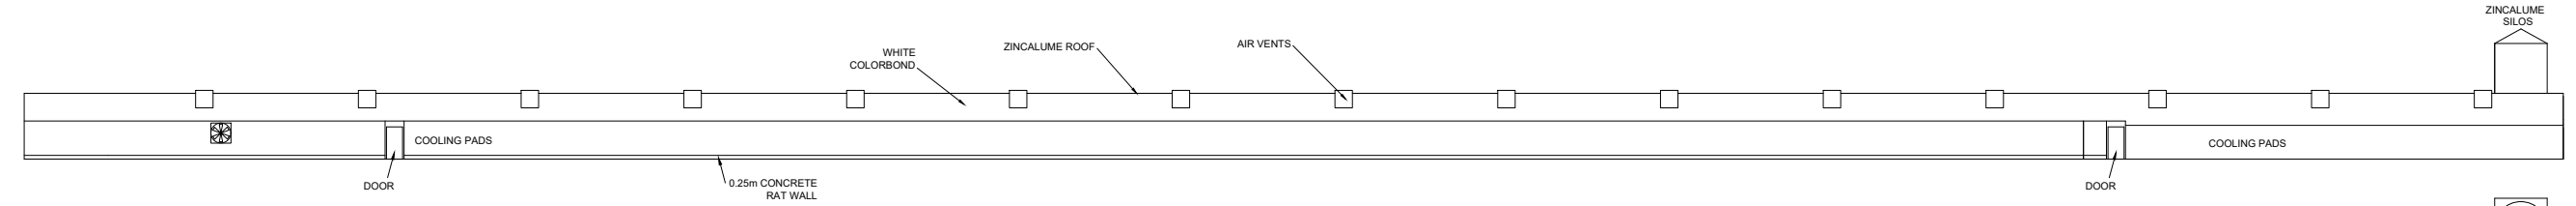

WEST ELEVATION
SCALE 1:250

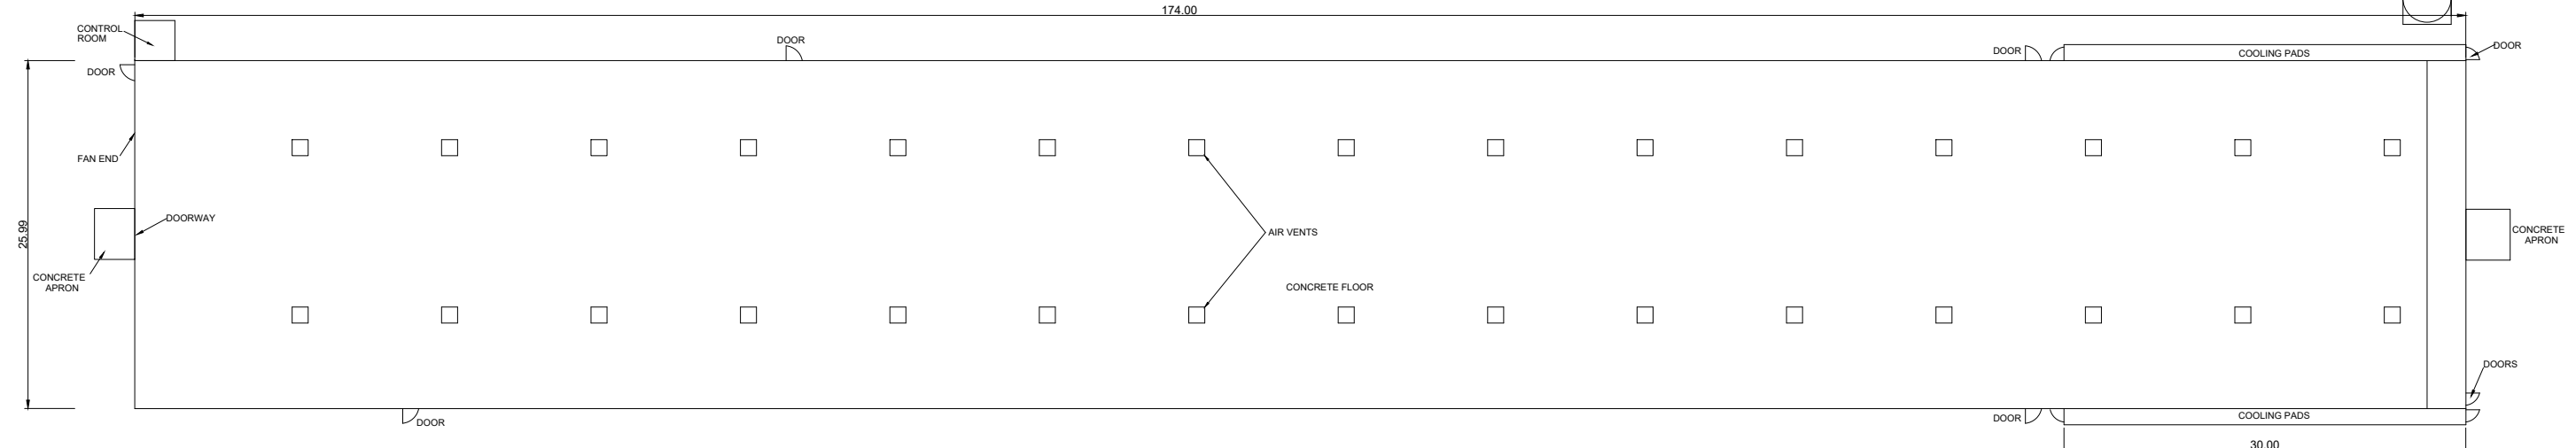

PLAN VIEW
SCALE 1:250


A	PRELIMINARY ISSUE	NM	22-07-2022	
B	SHED SIZE AMENDED	NR	14-03-2024	
C	SHED SIZE AMENDED	NR	22-03-2024	
REV	REVISION	BY	DATE	SHEET No.

NOTES


DESIGNED DATE: 22-07-2022
 DRAWN DATE: 22-07-2022
 CHECKED DATE:
 LAND MANAGEMENT SURVEYS (MELBOURNE)
 SURVEYORS ENGINEERS PLANNERS
 ABN 22 057 933 516
 34 BALCOMBE ROAD MENTONE 3194
 Ph. (03) 9583 0888 Fax. (03) 9583 5888
 DRG FILE No. O:\SH2023\4114 - Barrington Road Carrisbrook (LMS 12046
 ABCDE\IC3D\12046_Engineering_Farm-10_02(Farm Buildings)_DR.dwg

POULTRY FARM
 BALD HILL ROAD
 CARISBROOK
 FARM 10 - SHED DETAILS


SCALE AS SHOWN @ A1
 SHEET 5 OF 8
 REVISION C
 FILE No. 12046E

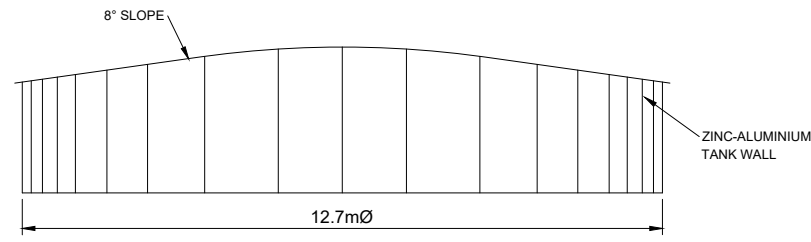


ELEVATION (2x SCALE)
SCALE 1 : 75

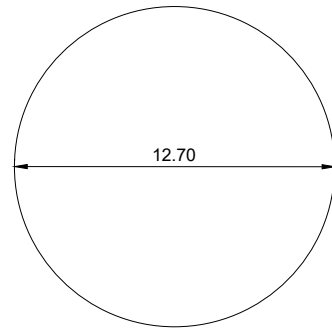


PLAN
SCALE 1 : 150
WATER TANK
250,000 LITRES

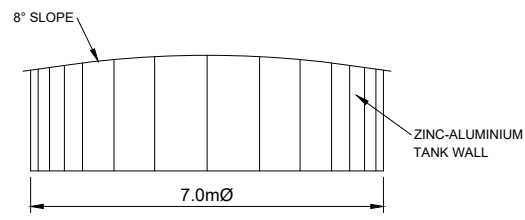


ELEVATION (2x SCALE)
SCALE 1 : 75

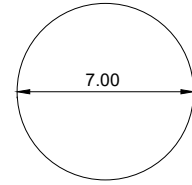


PLAN
SCALE 1 : 150
FIRE TANK
72,000 LITRES

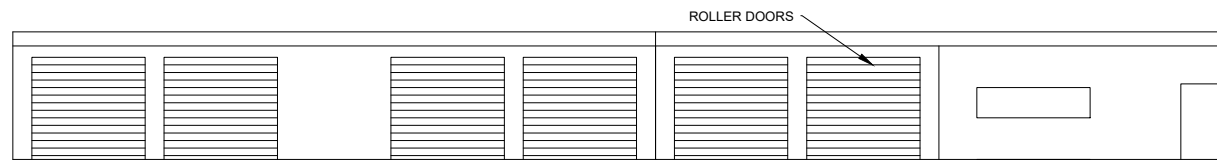

FRONT ELEVATION
SCALE 1:100

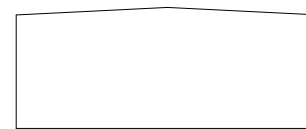

SIDE ELEVATION
SCALE 1:100

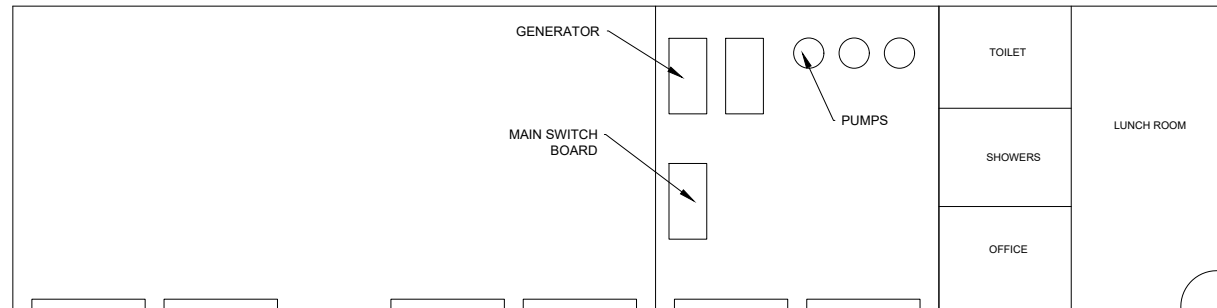

PLAN
SCALE 1:100
GENERATOR / AMENITIES ROOM

A	PRELIMINARY ISSUE	NM	23-02-2023	
REV	REVISION	BY	DATE	SHEET No.

NOTES


DESIGNED DATE	NM	20-02-2023
DRAWN DATE	NM	20-02-2023
CHECKED DATE		

LAND MANAGEMENT SURVEYS (MELBOURNE)
SURVEYORS ENGINEERS PLANNERS
ABN 22 057 933 516
34 BALCOMBE ROAD MENTONE 3194
Ph. (03) 9583 0888 Fax. (03) 9583 5888

DRG FILE No. O:\SH2023\4114 - Barrinhup Road Carrisbrook (LMS 12046
ABCDE\IC3D\12046_Engineering_Farm-10_02(Farm Bldgs)_DR.dwg

POULTRY FARM
BALD HILL ROAD
CARISBROOK
FARM 10 - BUILDING DETAILS


SCALE AS SHOWN @ A1
SHEET 6 OF 8
REVISION A
FILE No. 12046E

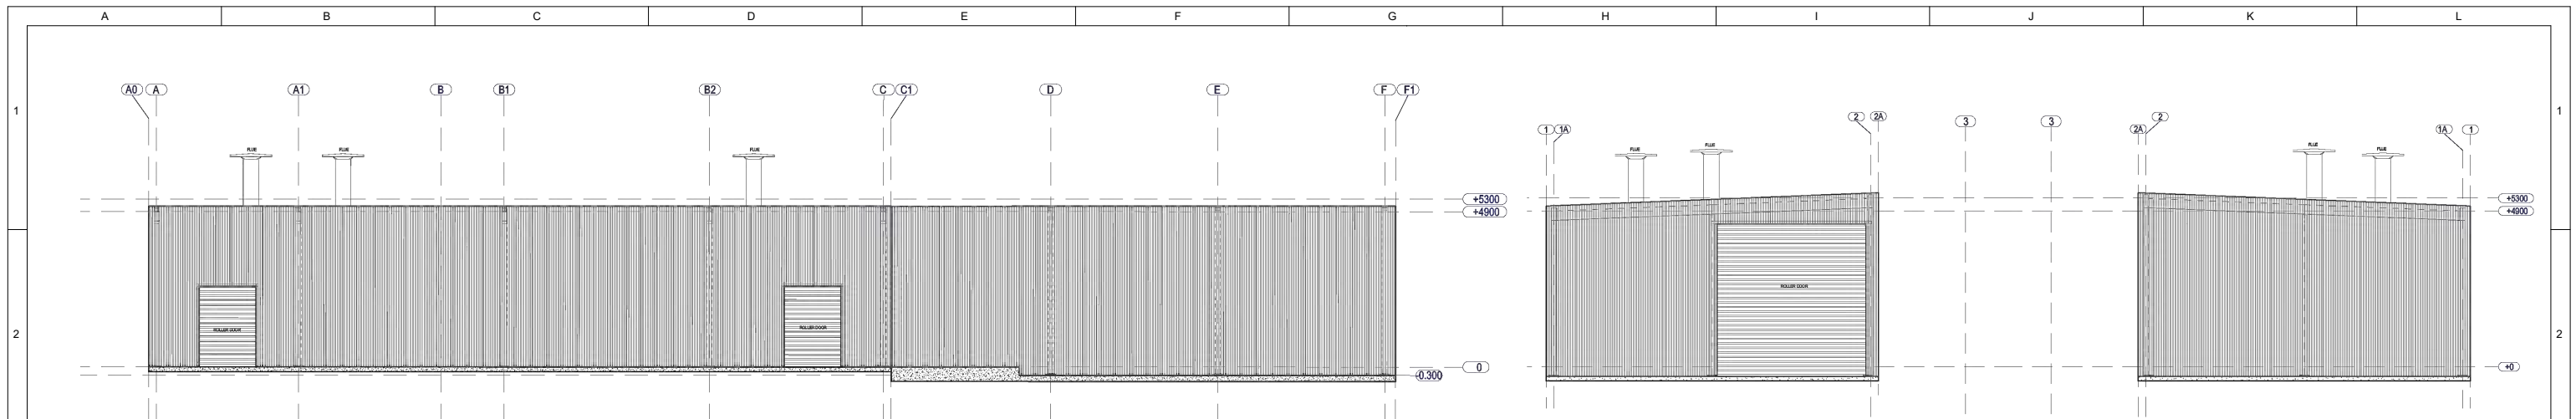


NORTH EAST ELEVATION
SCALE 1 : 100

NORTH WEST ELEVATION
SCALE 1 : 100

SOUTH EAST ELEVATION
SCALE 1 : 100

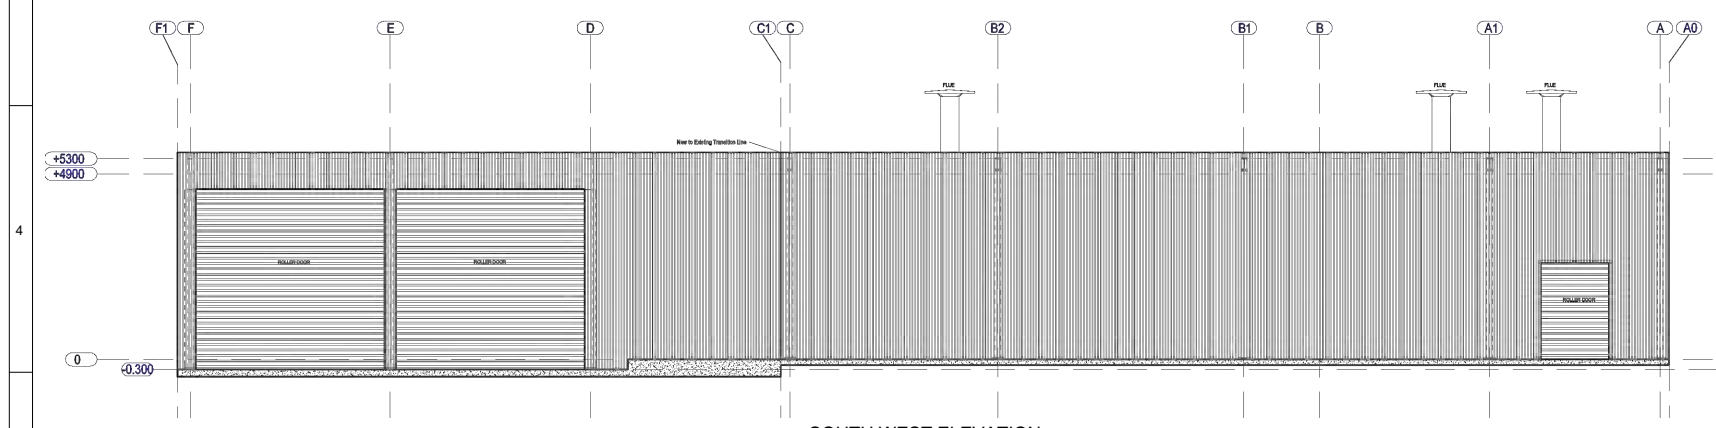

SOUTH WEST ELEVATION
SCALE 1 : 100

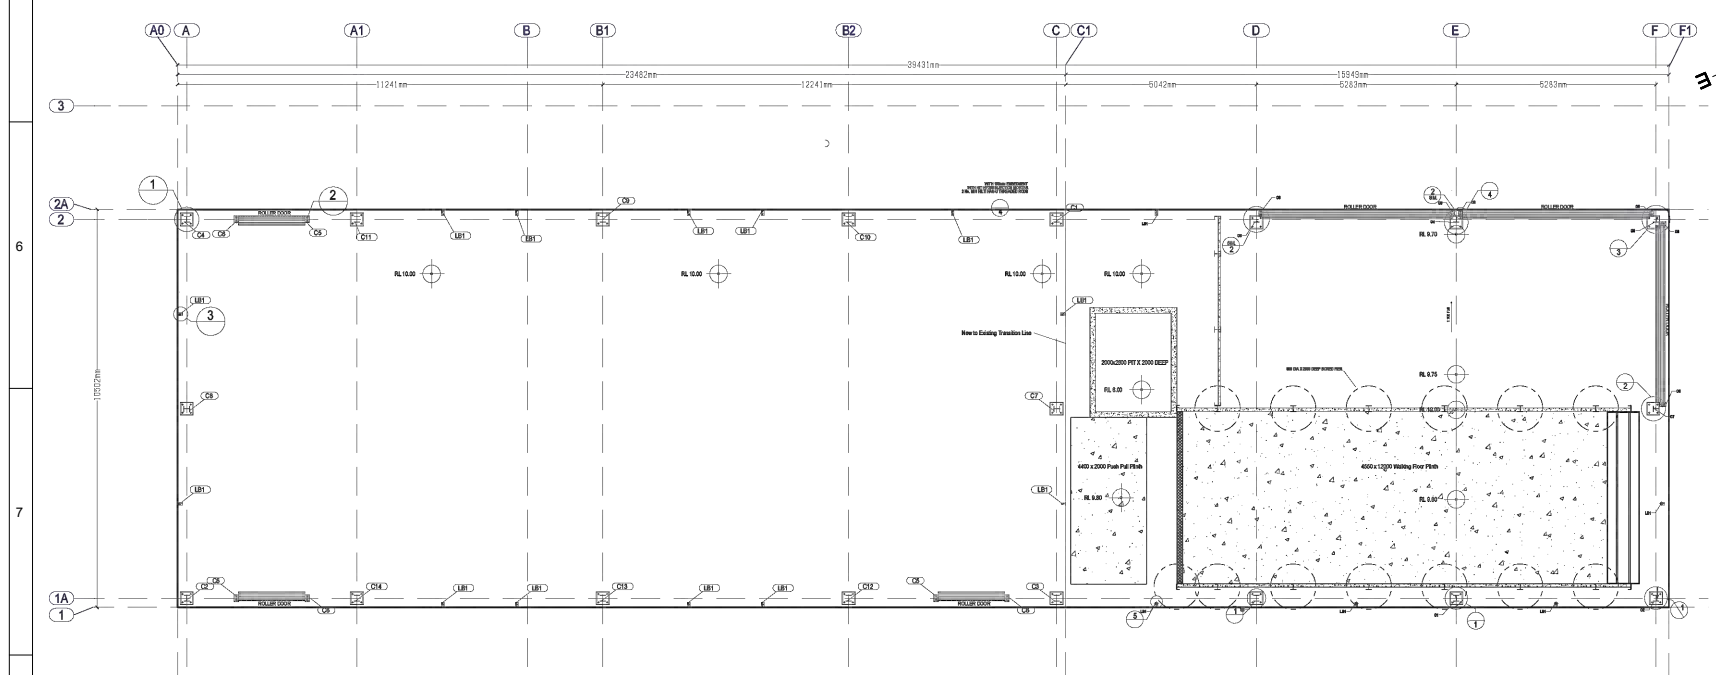

ENERGY FACILITY PLAN
SCALE 1 : 100



A	PRELIMINARY ISSUE	NM	23-02-2023	
8				
REV	REVISION	BY	DATE	SHEET No.
A		B	C	

NOTES







DESIGNED DATE	NM	20-02-2023
DRAWN DATE	NM	23-02-2023
CHECKED DATE		


LAND MANAGEMENT SURVEYS (MELBOURNE)
 SURVEYORS ENGINEERS PLANNERS
 ABN 22 057 933 516
 34 BALCOMBE ROAD MENTONE 3194
 Ph. (03) 9583 0888 Fax. (03) 9583 5888

DRG FILE No. O:\SH2023\4114 - Barrinhup Road Carrisbrook (LMS 12046
 ABCDE\JC3D\12046_Engineering_Farm-10_02(Farm Bldgs)_DR.dwg

POULTRY FARM BALD HILL ROAD CARISBROOK		SCALE AS SHOWN @ A1
		SHEET 7 OF 8
FARM 10 - ENERGY FACILITY DETAILS		REVISION A
		FILE No. 12046E

A B C D E F G H I J K L

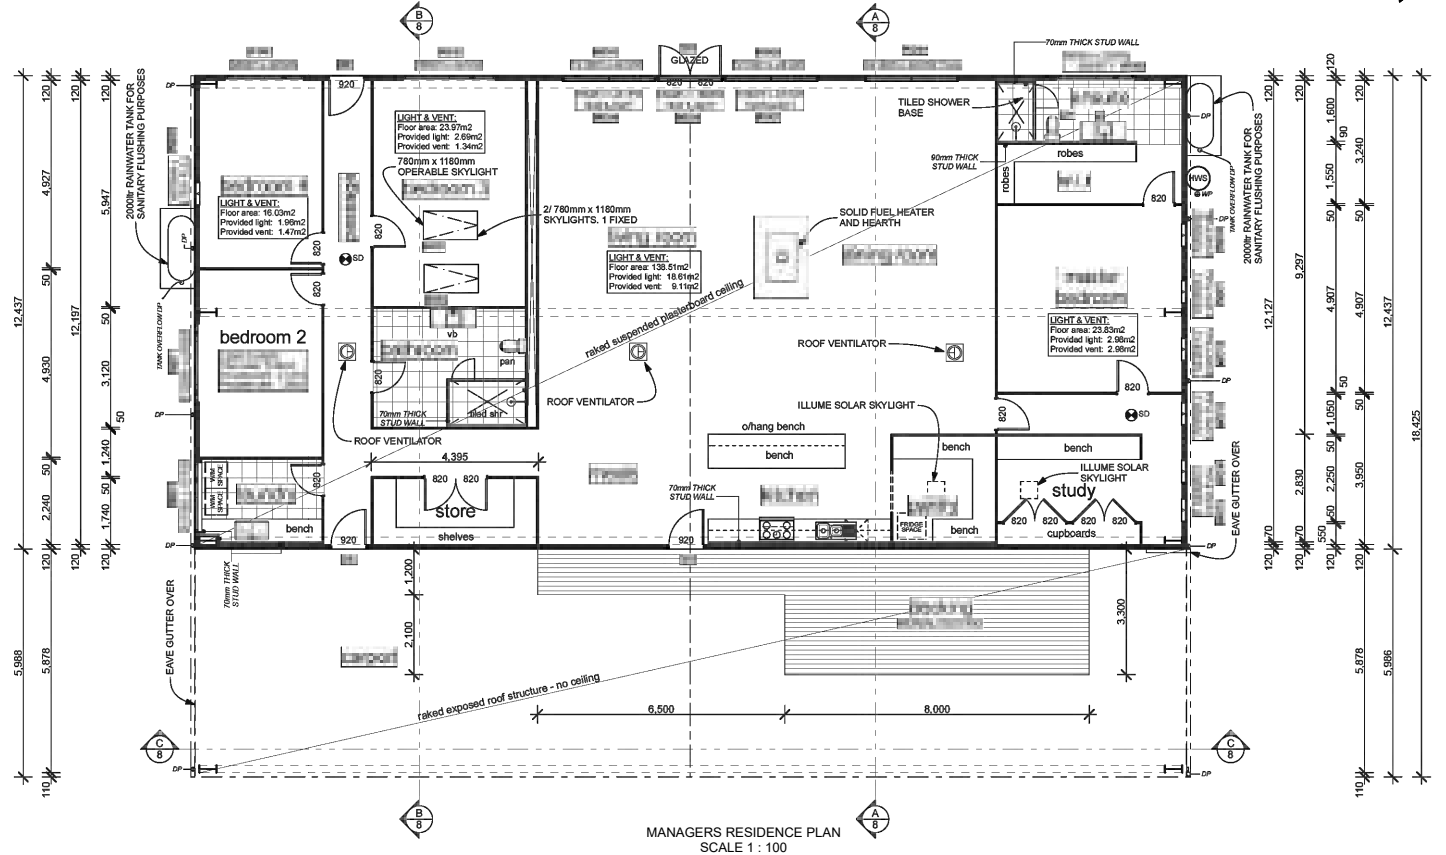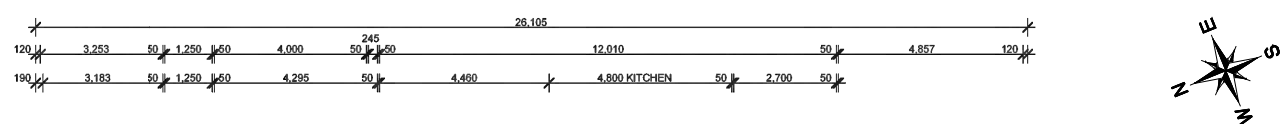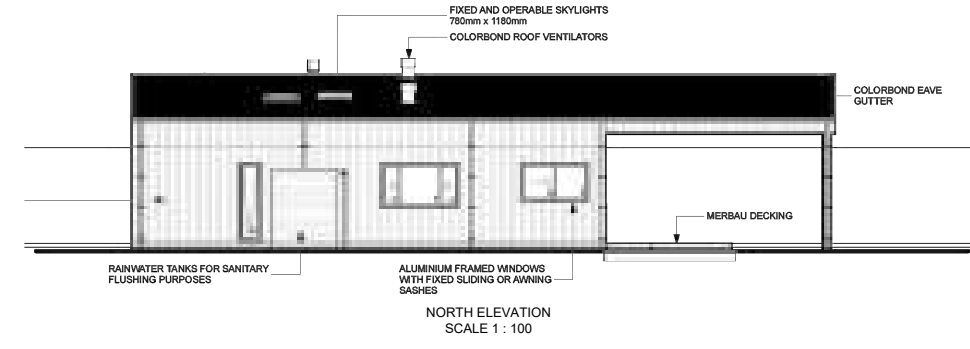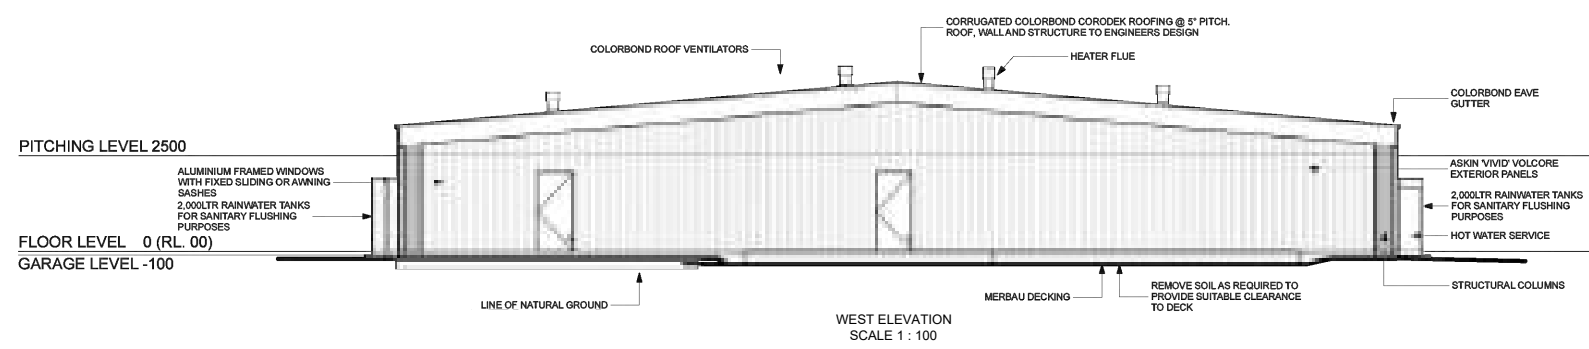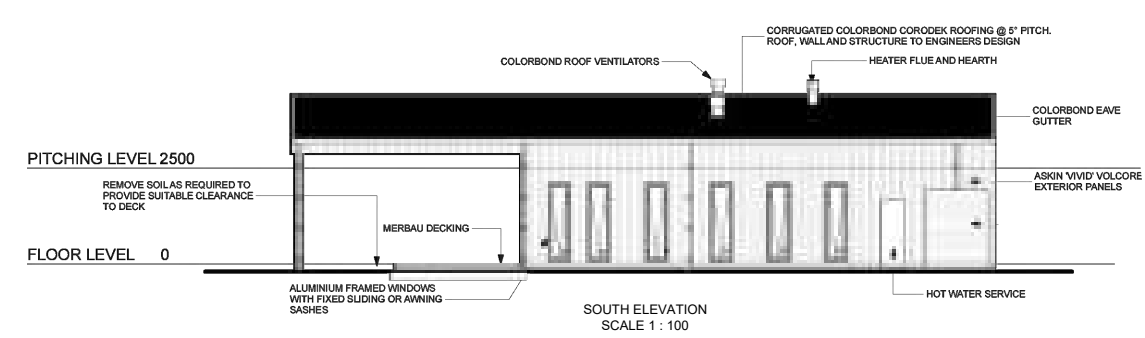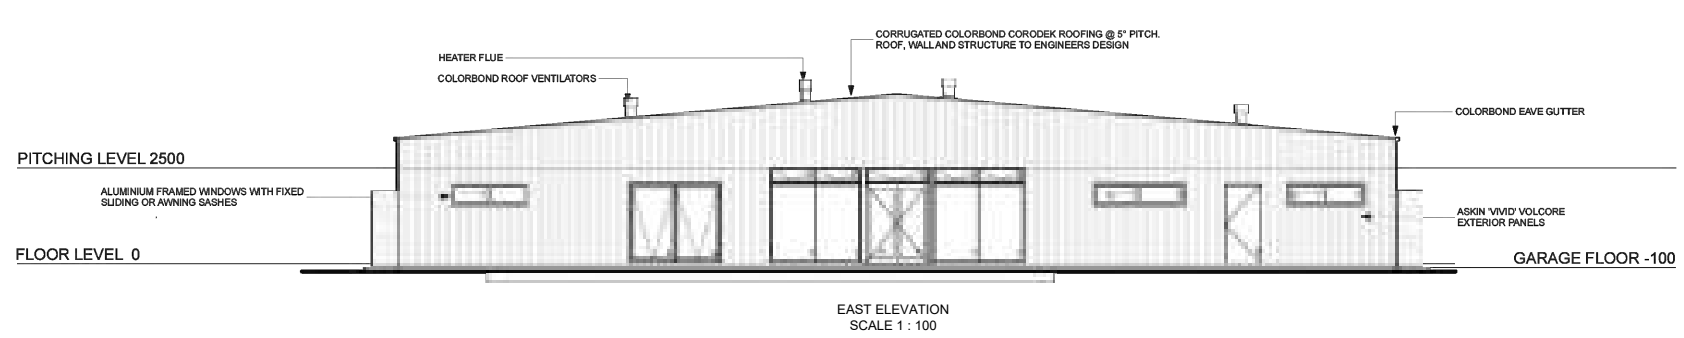

REV	REVISION	BY	DATE	SHEET No.
A	HOUSE LAYOUT	NM	23-02-2023	
B	HOUSE LAYOUT AMENDED	DR	15-05-2023	

NOTES

1. RAKED EXPOSED ROOF STRUCTURE - NO CEILING

DESIGNED DATE: NM 20-02-2023
 DRAWN DATE: NM 20-02-2023
 CHECKED DATE:

LAND MANAGEMENT SURVEYS (MELBOURNE)
 SURVEYORS ENGINEERS PLANNERS
 ABN 22 057 933 516
 34 BALCOMBE ROAD MENTONE 3194
 Ph. (03) 9583 0888 Fax. (03) 9583 5888

POULTRY FARM
 BALD HILL ROAD
 CARISBROOK

FARM 10 - MANAGERS RESIDENCE DETAILS

SCALE AS SHOWN @ A1
 SHEET 8 OF 8
 REVISION B
 FILE No. 12046E

A B C D E F G H I J K L